




**CITY OF ESCONDIDO**  
**CENTERLINE INTERSECTION TIES**

TIE # 502-A

DATE: 10/2014

5TH AVENUE @ CEDAR STREET

DRAWN: BH CHECKED: PF

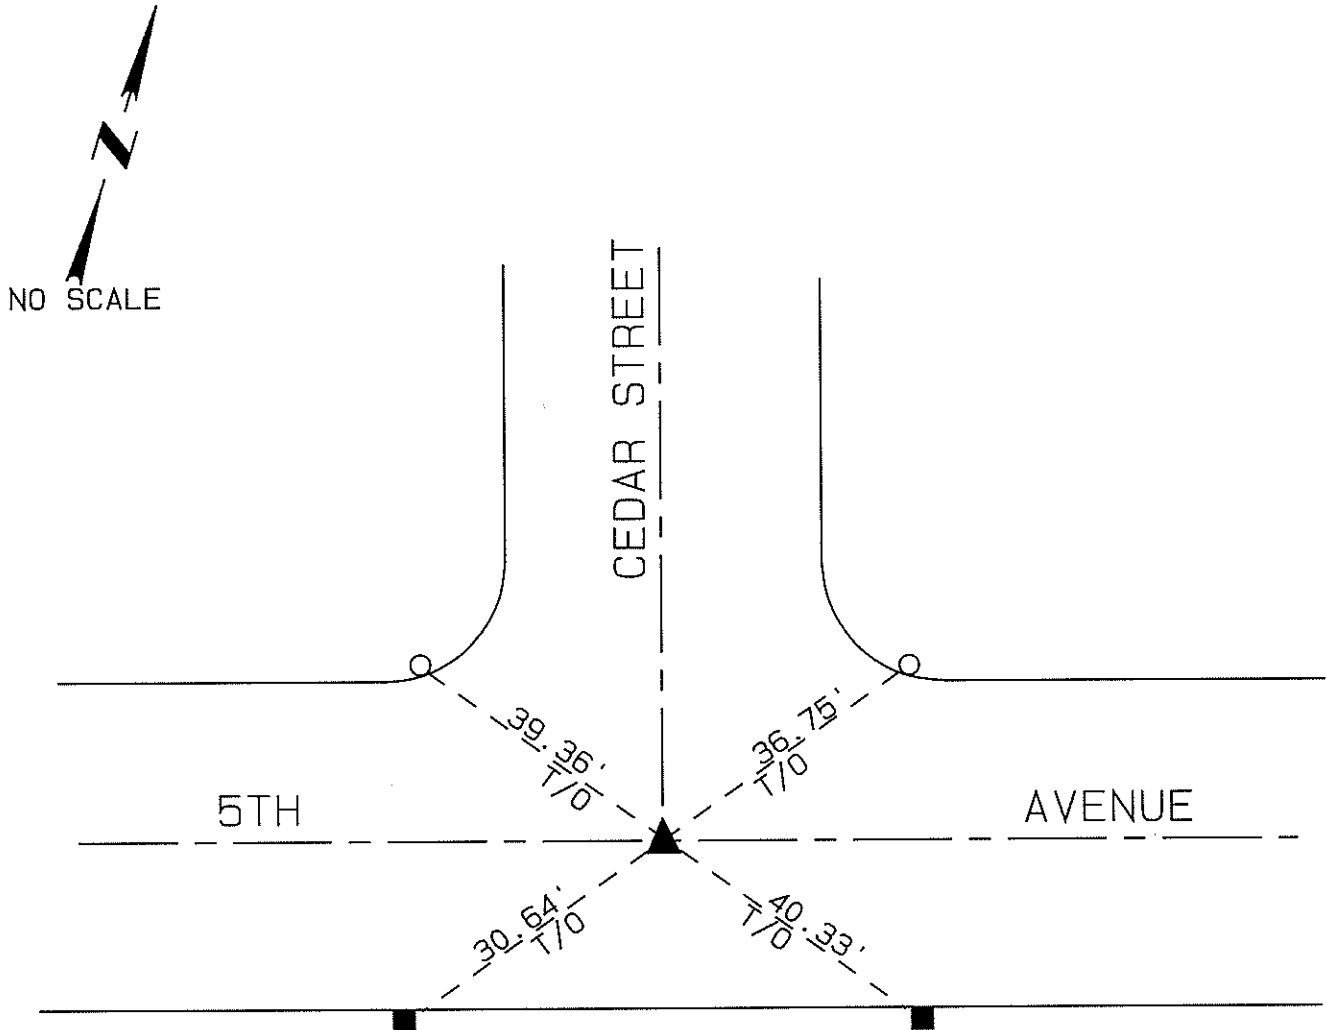

- ▲ — FOUND 4' PK NAIL CROSS TIES TO C/L INTERSECTION PER CORNER RECORD #16772. SCORE MARKS ON MANHOLE RIM NOT USED.
- — FOUND SCRIBE 'X' IN TOP OF CURB PER CITY TIE #502. SET LEAD AND TACK IN CENTER OF FOUND 'X'.
- — SET LEAD AND TACK IN TOP OF CURB.