
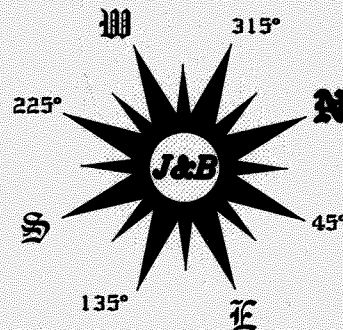


# TIE POINTS SURVEY FOR TRACK 696

## LEGEND

- INDICATES EXISTING SPIKE AND TIN OR 4-PUNCH MARKS ON MANHOLE PER ESCONDIDO TRACT NO. 696 MAP NO. 13281
- ⊗ INDICATES SET LEAD AND TACK ON CONCRETE PAVEMENT OR TOP OF CURB

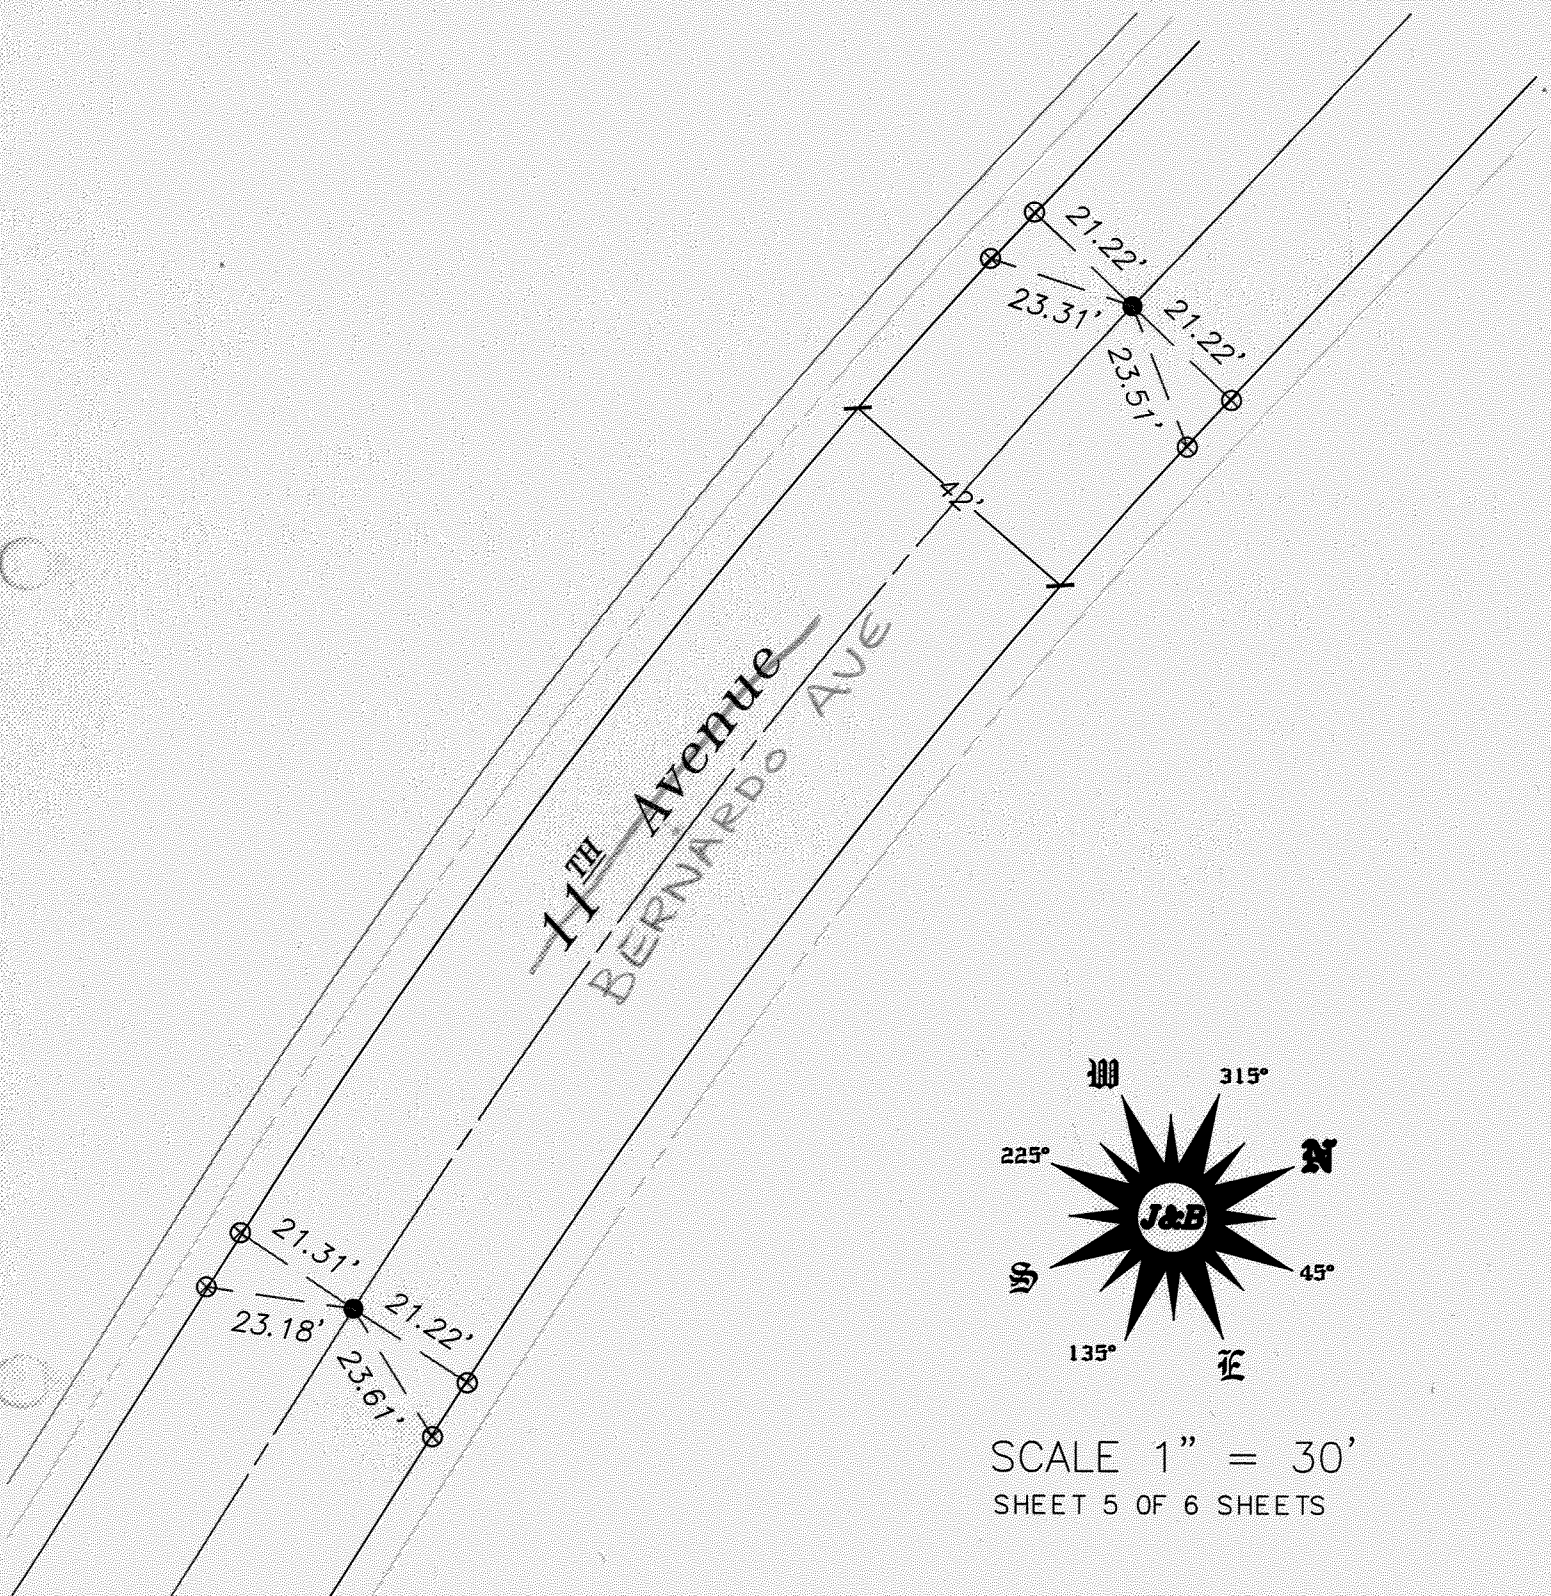

SCALE 1" = 30'  
SHEET 5 OF 6 SHEETS