
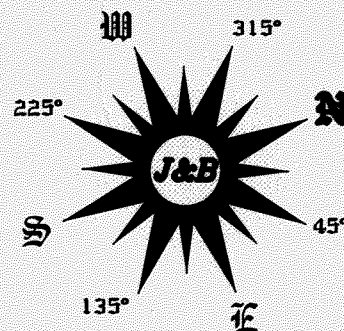


TIE POINTS SURVEY FOR TRACK 696

LEGEND

- INDICATES EXISTING SPIKE AND TIN OR 4-PUNCH MARKS ON MANHOLE PER ESCONDIDO TRACT NO. 696 MAP NO. 13281 .
- ⊗ INDICATES SET LEAD AND TACK ON CONCRETE PAVEMENT OR TOP OF CURB

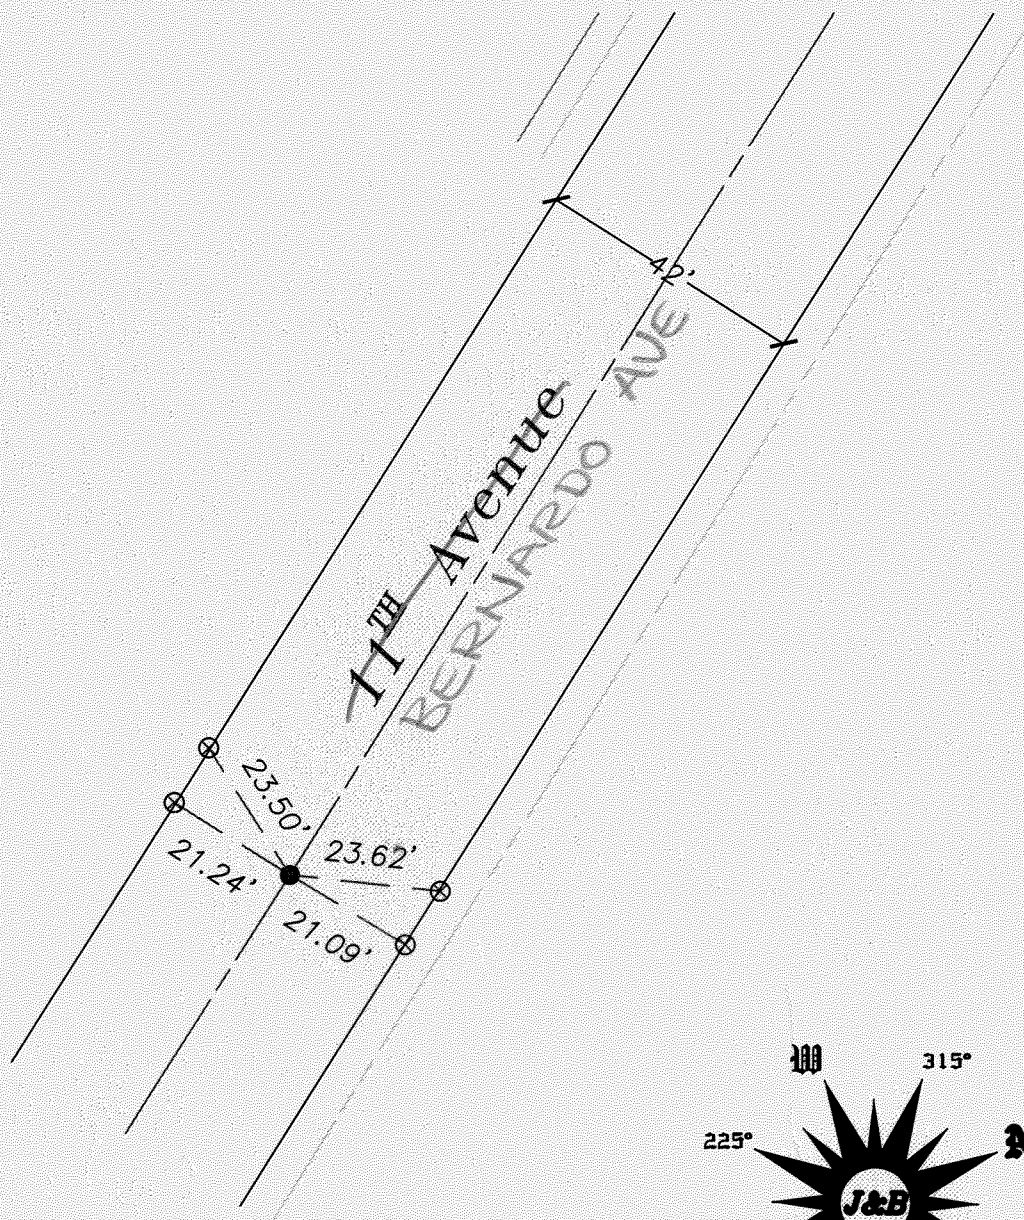

SCALE 1" = 30'
SHEET 6 OF 6 SHEETS