



CITY OF ESCONDIDO
CENTERLINE INTERSECTION TIES


TIE # 1595

DATE: 7/2014

CANTERBURY PLACE CUL-DE-SAC

DRAWN: PF CHECKED: PF

MAP 13472

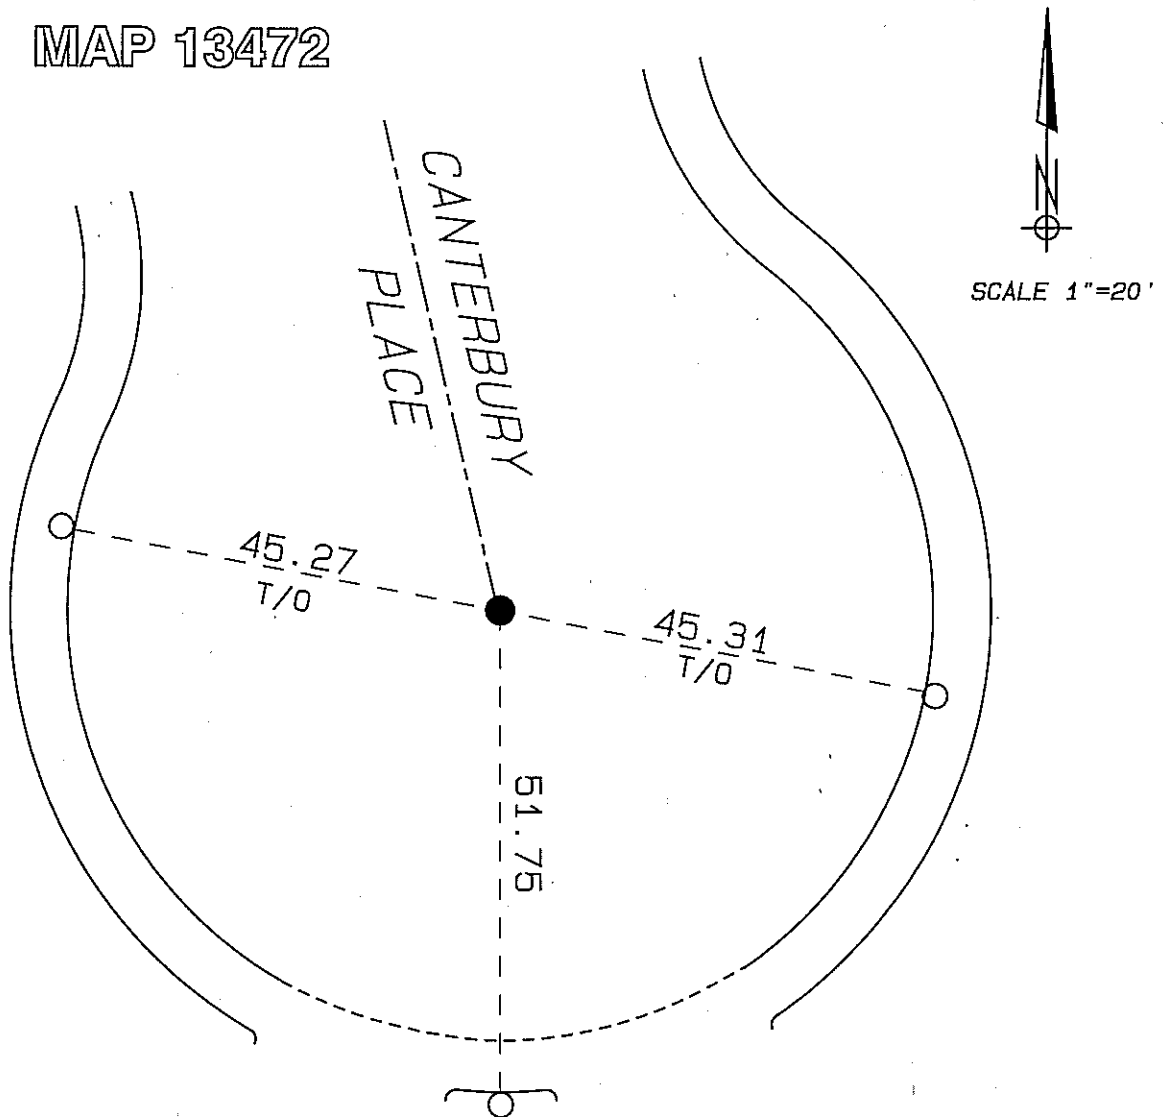

● — FOUND FOUR 6.00' NAIL STRADDLE TIES TO RADIUS POINT
PER MAP 13472. RADIUS POINT FALLS ON MANHOLE LID.

○ — SET LEAD AND TACK IN TOP OF CURB.